


MEMORANDUM

FINANCE MEMO – 19-017

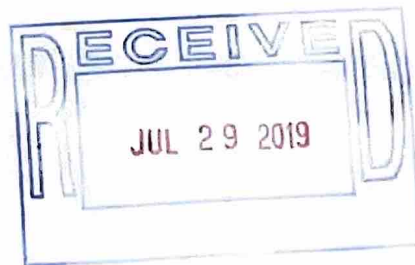

TO: Angela Lane, Finance Director

FROM: Ray Clarke, County Engineer

DATE: July 12, 2019

SUBJECT: Check Request – Talbot County Environmental Health
Sanitary Construction Permit Fee – OSDS Program

In 2006, the Maryland Department of the Environment allocated Talbot County \$1.1 million to design and install denitrifying treatment systems on individual on-site sewage disposal systems (septic systems). These funds are associated with the Bay Restoration Fund (Flush Fee) that is assessed for each property in the unincorporated areas. The Department of Public Works has processed the easement and is presently engaged in the installation of the denitrifying treatment unit for the residential structure that exists on the property listed below:

PROPERTY OWNER: William & Sue Gallagher
PROPERTY LOCATION: 27047 Presquile Rd, Easton MD 21601
TAX ID: 01-083295 (Tax Map 0009, Parcel 0029)

In accordance with the FY2010 budget, please process a check in the amount of \$600 for the Sanitary Construction Permit being issued by the Talbot County Environmental Health Office. This charge should be assessed to OSDS 7900, Other Operating Expenses. If you have any questions concerning this matter, please contact me at your earliest convenience. Thank you for your assistance in this matter.

cc. Anne Morse, Environmental Health Director
OSDS DNU Disbursement File
OSDS DNU File

APR - 6 2018

TALBOT COUNTY HEALTH DEPARTMENT

OFFICE OF ENVIRONMENTAL HEALTH
215 BAY STREET, SUITE #4, Easton, MD 21601
410-770-6880 (P) 410-770-6888 (F)

Building Permit No. _____
Receipt No. _____

APPLICATION FOR SANITARY CONSTRUCTION PERMIT

This permit is for an interim individual septic system. The property owners must discontinue use of this individual system & connect to the community system when the community system becomes available.

1. OWNER Gallagher, William, 27047 Presquile Road, Easton, MD 21601

Last Name First Name Mailing Address E-Mail Address

2. APPLICANT Tyler Contracting Co. Fax#410-745-2373 tylerconco@aol.com

Last Name First Name Phone No. E-Mail Address

3. Size of Lot 19.81 acres 4. Planned Use of Building: Residential Commercial: Type _____

If Residential: Sq. Ft. of Living Area _____ # of Bedrooms three

5. Type of Sewage Disposal System: On-Site Septic System Connection to Public Sewer

6. Type of Water Supply: Deep Well Shallow Well Community Water Supply

7. [Signature] hereby agree to have the sewage disposal facilities installed in accordance with regulations COMAR 26.04.02 of the Maryland Dept of Environment under the supervision of the Talbot County Health Dept. Should this system fail, I agree to make any changes deemed necessary. THIS APPLICATION SHALL EXPIRE ONE YEAR FROM THE DATE OF APPROVAL.

Date 4/5/18

IMPORTANT: NO BUILDING CONSTRUCTION OR SANITARY CONSTRUCTION SHALL BE STARTED BEFORE RECEIVING APPROPRIATE PERMITS. ANY CHANGES IN SANITARY CONSTRUCTION MUST HAVE THE APPROVAL OF THE ENVIRONMENTAL HEALTH SECTION OF THE TALBOT COUNTY HEALTH DEPARTMENT.

DO NOT WRITE BELOW THIS LINE. OFFICIAL USE ONLY

8. Purpose of Sanitary Construction:

- New System Expansion of Existing system
- Repair/Replacement Connection to Existing System
- Abandon tank/pit. Tanks/pit must be pumped prior to being crushed, filled or removed.

9. BAT Required 450 GPD

10. Septic Tank Specifications: Number of Tanks _____ () Top Seam Tank

- 1,000 Gallon Two Compartment
- 1,500 Gallon Two Compartment
- Concrete Pump Chamber 5x5

11. Total Length of Trench 220 ft. Length of Each Trench 110 Number of Trenches 2

Depth of Each Trench 6 ft Width of Trench 2 ft.

Sand Lined Trenched/6" Stone Below & 2" Above All Stone Trench _____

Invert of Drainfield 0" at point of highest elevation Install When Ground Water Table is Absent

Soil Type MKA/HFC Management Area B Graded & Seeded

Drainfield location as proposed by Tyler Contracting on 4/4/2018.

Maryland Dept. of the Environment recommends septic tanks, BAT and other pre-treatment units be pumped at a frequency adequate to ensure that solids are not discharged to the disposal area.

THE ABOVE REFERENCED DENITRIFICATION UNIT MUST BE INSTALLED IN ACCORDANCE WITH THE MANUFACTURER'S GUIDELINES. FINAL APPROVAL FOR SANITARY CONSTRUCTION INSTALLATION WILL NOT BE PROVIDED UNTIL A COPY OF THE MANUFACTURER'S INSTALLATION CERTIFICATION HAS BEEN PROVIDED TO THIS OFFICE.

Application Approved 4/24/2018
Date

Margaret DeJker, LEHS
Registered Environmental Health Specialist

Map 9

GRID


PARCEL 29

LOT #

AS-BUILT DRAWING

Date & Time of Inspection(s) 8/16/18 @ 1000

System Installed By: Tyler

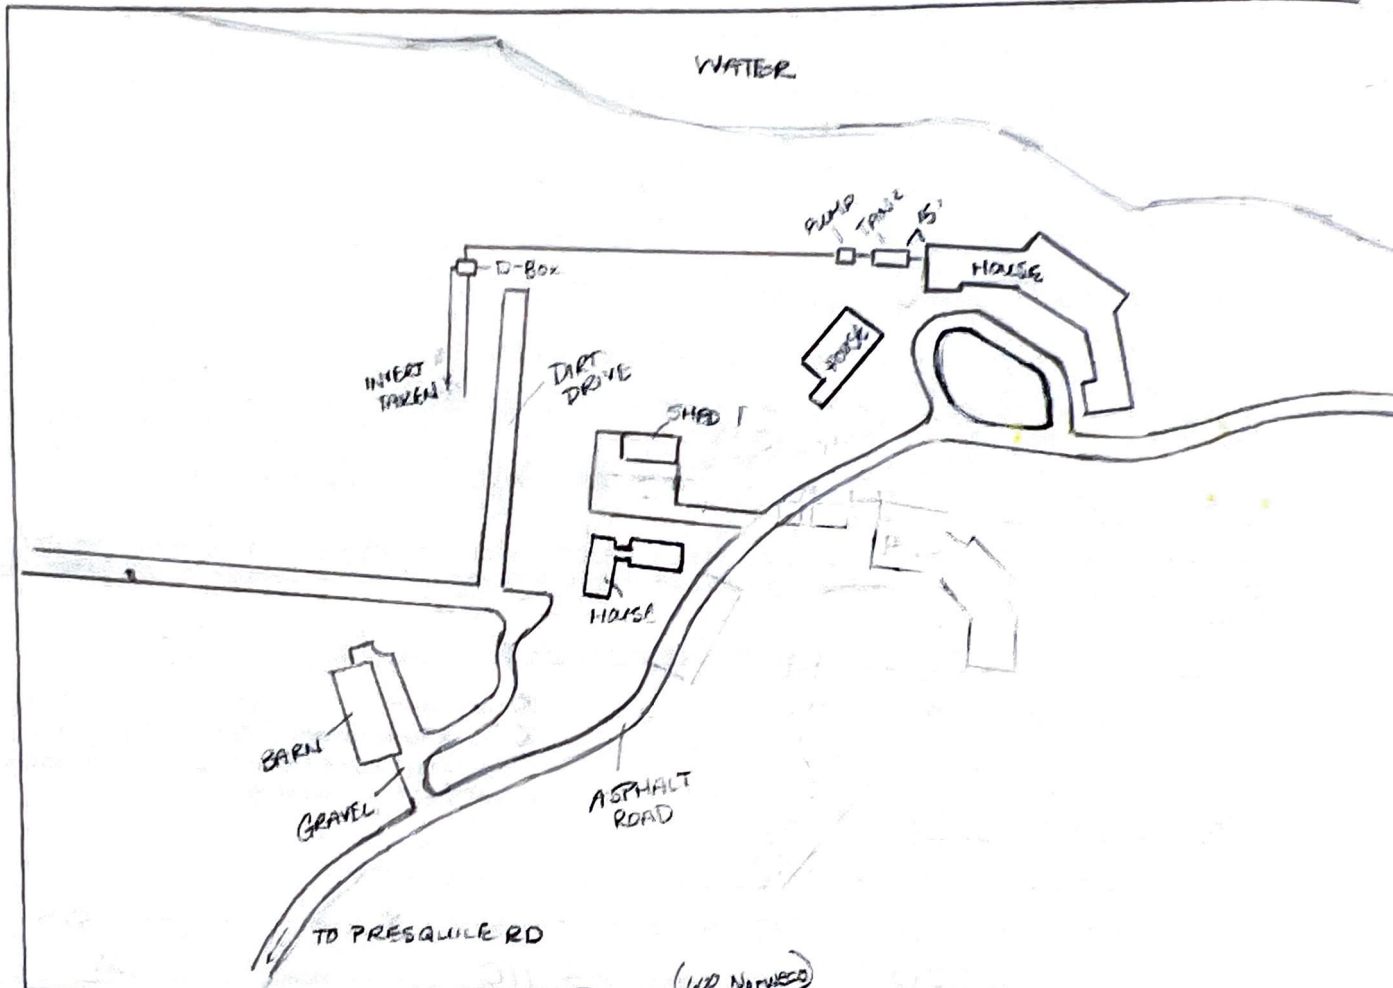


(NO NOTES)
Final Inspection Observations: 8/16/18 (PWAY) Tank and Pump have been set and leveled. Drain Field to be installed next week per contract. 8/22/18 the second trench was being dug. The trenches were 6' deep with a 5/16" bottom. The invert line at grade is higher w/c. 3/4" clean stone and paper lining. JSD

X) Certification of Installation of BAT provided

Licensed Environmental Health Specialist Clayton Owen L.E.H.S., 6/26/19



Towers Concrete Products, Inc.
26425 Hobbs Road Denton, Maryland 21629
Telephone: 410-479-0914 Fax: 410-479-0030
1-800-773-9128

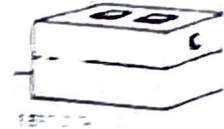

Ready Mixed Concrete – Septic Tanks – Drainage Supplies

On this 16th day of August 2018, the homeowner(s), William Gallagher own(s) a tract of land located at 27047 Presquile Road Easton in Talbot County, Maryland.

Whereas: the Bay Restoration Fund (BRF) has provided a grant for the cost of an MDE-approved Best Available Technology (BAT) Norweco Singulair TNT nitrogen removal wastewater treatment system.

Towers Concrete Products, Inc., the manufacturer, distributor and service provider, delivered and set the Singulair system in place.

Owner acknowledges and agrees that a Towers Concrete Products, Inc. approved and certified installer installed the Singulair TNT system.


Owner acknowledges and agrees that a Towers Concrete Products, Inc. certified technician installed all internal components and made certain they are properly functional.

A Towers Concrete Products, Inc. representative observed the installation and by his signature below, agrees the unit has been installed in accordance with this company's installation instructions, and this job is considered complete.

The homeowner, by his/her signature below agrees the job has been completed to his/her satisfaction.


Towers Concrete Products, Inc. Representative's Signature

08-17-2018
Date

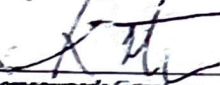
Homeowner's Signature

8-16-18
Date

APR - 6 2018



Towers Concrete Products, Inc.
26425 Hobbs Road, Denton, Maryland 21629
Telephone: 410-479-0914 Fax: 410-479-0030
1-800-773-9128




Ready Mixed Concrete - Septic Tanks - Drainage Supplies

Talbot County Health Department
Office of Environmental Health
215 Bay St., Suite 6
Easton, Maryland 21601


Towers Concrete Products, Inc. will be supplying a Norweco Singlair 600 GPD TNT Unit, to treat a 1-4 bedroom home, to William Gallagher on the property located at 27047 Presquille Road, Easton, MD 21601. The excavation and installation will be completed by Tyler Contracting a contractor located in St. Michaels, MD. This agreement is valid one year from the date the agreement is signed.

The above information is complete and accurate as evidenced by the signatures of all parties below:




Jeffrey Powell
Towers Concrete Products Representative

04-06-18
Date



WALTER TYLER
Tyler Contracting - Contractor

04/06/18
Date

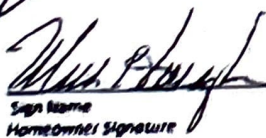

William L. Gallagher
Homeowner's Signature

4/5/18
Date



TALBOT COUNTY HEALTH DEPARTMENT
OFFICE OF ENVIRONMENTAL HEALTH

215 BAY STREET - SUITE 4
EASTON, MARYLAND 21821
TEL: (410) 770-8885
FAX: (410) 770-8888

"TYLER"

Bay Restoration Fund SB554 Project Identification

Property Owner Name: WILLIAM GALLAGHER

Property Address: 27047 PRESQUILE RD

MBP: M-9 P-29

For BRF grant eligibility, a representative from the TCHD has verified the following criteria:

(1) Your property is located in the Critical Area: YES NO

(2) Your current septic system is failing based on the following factors: YES NO

- Sewage backing up into a house
- Sewage surfacing onto the ground surface
- Collapsed septic tank
- System identified and verified as contaminating a specific well

* failure determination based on Septic Evaluation done by Pete Tyler on 3/22/2018.

(3) You are required to install a Best Available Technology (BAT) unit due to new construction requirements. YES NO

Megan DeJeter
Signature of Registered Sanitarian

4/24/2018
Date



302 Dodson Avenue
P.O. Box 960
Saint Michaels, MD 21663
410-745-2323
410-745-2373 Fax

4/9/18

Revised
Submitted w/
Corrected 911
addresses.

March 12, 2018

William Gallagher
8419 Ingleton Road
P.O. Box 752
Easton, MD 21601

Dear William Gallagher,

In response to your request for a septic system evaluation, we did an evaluation of the septic system on the property at ~~27017~~ ²⁷⁰⁴⁵ Presquile Rd in Easton, MD;

Main House

Date of Inspection: March 08, 2018.

Original Installation Date: About 1968.

Location of System:

The septic system is located next to the house as shown on the diagram. (Not to scale). The tank was recently pumped as part of the current inspection.

Septic Tanks:

There is one, 1000 gallon concrete aerobic septic tank. The tank was in good and acceptable condition. An inlet baffle was never installed into this tank system. The lids are in good condition. The liquid level was normal in the septic tank. The sludge and scum levels were normal. Liquid from the tank then runs towards a distribution box. The septic tank was in good and acceptable condition.

Piping:

The septic system consists of cast iron and plastic pipe. The piping from the house to the septic tank is cast iron. The piping to the distribution box and drain fields is plastic pipe. The piping appeared in good and acceptable condition.

Distribution Box:

There is one concrete distribution box. The distribution box is in fair condition. 300 gallons of liquid was introduced into the distribution box and it did not drain toward the drain fields. The distribution box should be replaced as it has deteriorated over time.

Drain Field Trenches:

There are three drain field trenches totaling 192 feet of trench.

2


Two trenches are approximately 50 feet in length, and the center drain field trench is approximately 92 feet in length. The trenches did not accept liquid from the distribution box. Therefore, the absorption system is in unacceptable condition.

Summary: The 1000 gallon septic tank is in good and acceptable condition. The septic tank drains into a distribution box. The distribution box is in fair condition and should be replaced. Attached to the rear of the distribution box are three drain field trenches. The drain field trenches did not accept 300 gallons of liquid. The absorption system is in unacceptable condition.

Company Disclaimer

Based on what we were able to observe and our experience with on-site wastewater technology, we submit this Sewage Treatment System Inspection Report based on the present condition of the on-site sewage treatment system. Tyler Contracting Co. has not been retained to warrant, guarantee, or certify the proper functioning of the system for any period of time in the future. Because of the numerous factors (usage, soil characteristics, previous failures, etc.) which may effect the proper operation of a septic system, as well as the inability of our company to supervise or monitor the use or maintenance of the system, this report shall not be construed as a warranty by our company that the system will function properly for any particular buyer.


Tyler Contracting Co. disclaims any warranty, either expressed or implied, arising from the inspection of the septic system or this report. We are also not ascertaining the impact the system is having on the ground water. I have studied the information contained herein and that my assessment is honest, thorough, and to the best of my ability, correct.

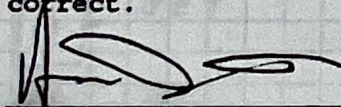

John W. Tyler
Henry J. Tyler
Tyler Contracting Company
NAWT/MOWPA Certified Septic Inspector

27047

Each Square Equals 5 Feet

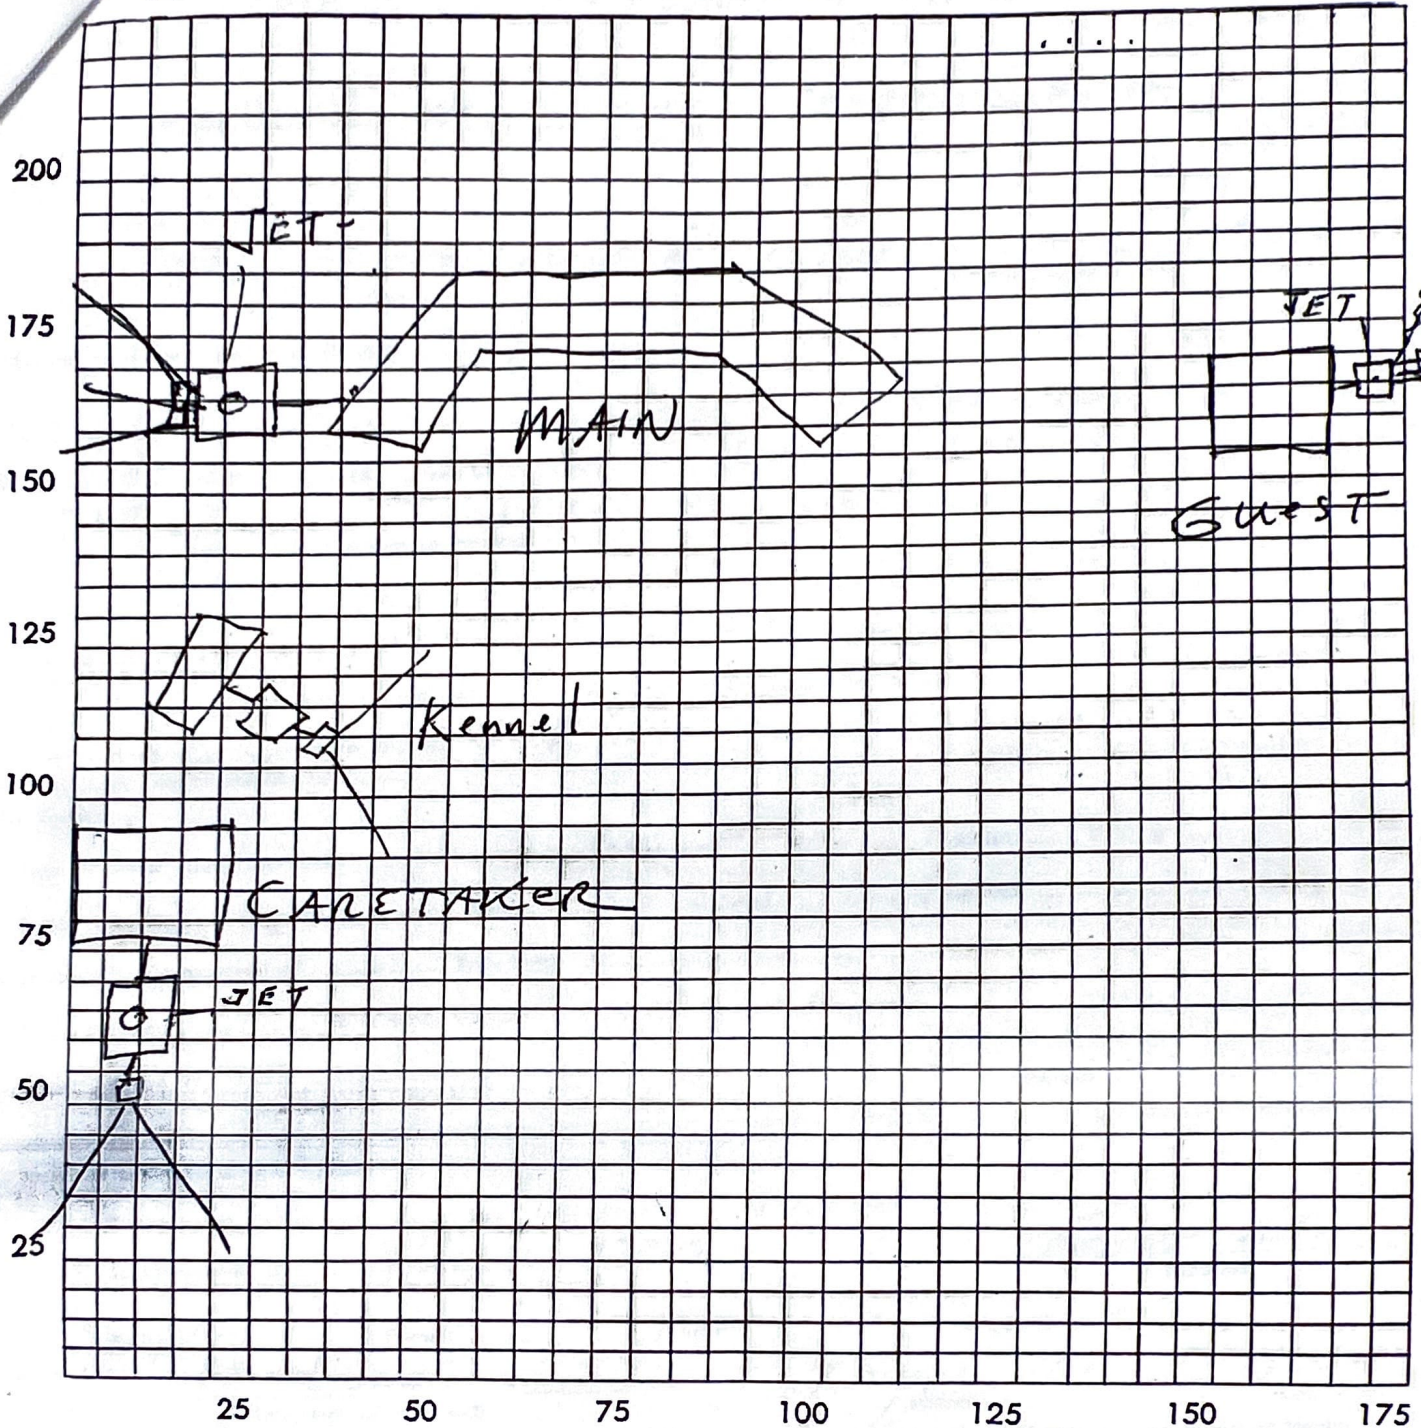

Make a sketch showing property lines (except in cases of farm installation) building location and showing exact location of waste line from house. Designate direction of slope and distance to house from property lines, and distance of all nearby sources of water to sewage disposal system.

Location and type of disposal system and well will be determined from results of percolation test.

Note: Notify the County Health Department at least forty eight (48) hours before you are ready to start installation, so inspection can be made while work is in progress.

Representatives of the County Health Department may make inspections during construction to determine compliance with the Regulations of the State Board of Health and the Local Board of Health. No part of any installation shall be covered until inspected and given final written approval by the County Health Department. Any part of an installation which has been covered prior to final approval shall be uncovered on order of the County Health Department.

Application approved: _____

Application disapproved: _____

Reason for disapproval: _____

DATE: _____

Sanitarian

Supervisor

Complete
TALBOT COUNTY HEALTH DEPARTMENT

Easton, Maryland

Telephone TALbot 2-2292

Application for

{ SEWAGE SYSTEM WELL }

Construction Permit

Permit No. 1872

Complete three copies and mail to Health Department Office

1. Owner: ~~Ret~~ AUGUST BELMONT % Fred Rogawski, Oxford Md.
(name) (present mailing address)

2. Builder or General contractor (if any) _____ (name) _____ (address)

3. State exact location of property or Subdivision name and Lot Number Miles River Neck near
Geo. Olds on Presquid Rd. - COURT Rd farm
249.676 ac Tobbs Cor to Presquid Rd. A-9-22-7
(Give detailed road directions so Inspector can find site)

4. Size of lot farm ft. x _____ ft. 5. Is it in the limits of a town Yes _____ No 4000
plus kennel + greenhouse waste

6. Planned use of building: Residence Commercial _____ New Remodeling _____ Addition _____

If residence state number of bedrooms 4 Number of Persons 24 hr. period 2

Is use of garbage grinder planned Yes No _____ Automatic washing machine Yes No _____

Water System

7. Type of water supply: Municipal _____ Drilled well _____ Driven well _____ Other _____ Proposed _____ Existing _____

8. Depth _____ Diameter _____ Casing Depth _____ Grouted _____ Grouting material _____

9. Distance from contamination _____ Type Pump _____ Location _____ ft. from well

10. Pump enclosure _____ Ft. to Water Surface _____ Suction line cased _____

11. To be installed by _____ (name) _____ (address)

12. Proposed sewerage disposal system:

Connection to public sewer _____ Septic tank system Approved privy _____

To be installed by Wearns Bros (name) TIRAPPE Md. (address)

13. I, E. J. Shlem (signature of applicant), Trappe Md. (address), 822 0510 (phone no.)
Builder _____ Owner _____ Plumber _____ Contractor

hereby agree to install sewerage disposal facilities in accordance with regulations of the Maryland State Board of Health.

14. Date of this application Oct 31, 1968

IMPORTANT: The applicant must arrange for necessary soil test. No construction shall be started before receiving County Health Department approval.

15. Soil test results: Percolation Test 0 minutes. Depth to porous soil 3 ft. Depth of porous soil 5 ft.

16. Septic tank capacity 2-600 gallons. Type of tank conc Size of tank _____ Length _____ Width _____ Depth _____

17. Tile field (if used) Total length 300 ft. Number of trenches 4
Length of each trench 75 ft. Width of each trench 1 1/2 ft.

18. Seepage Pit (if used) Total depth _____ ft. Size _____ ft x _____ ft. Number _____


Effective depth _____ ft. Sq. ft. of seepage area _____ Fill required _____ Tons.

(Detailed sketch must be completed on other side)

ONC. MON.
Belmont, August

Changed to JET'S

Each Square Equals 5 Feet

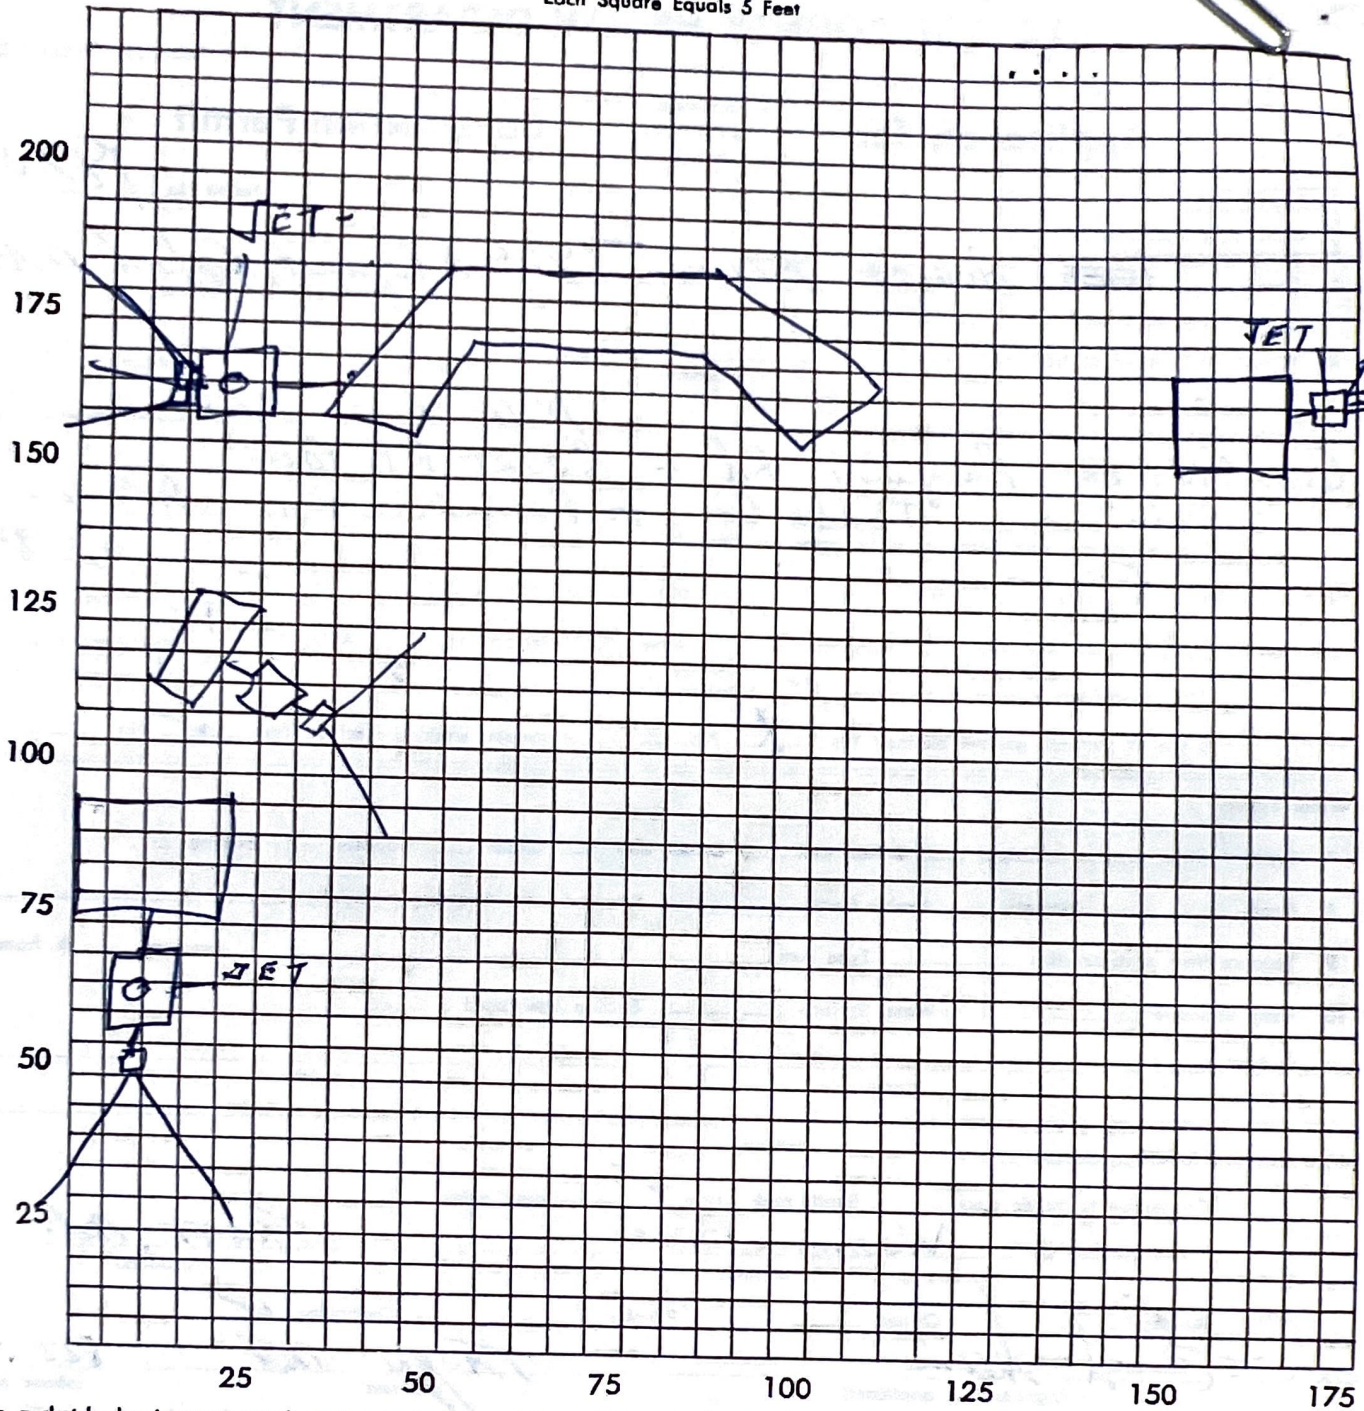

Make a sketch showing property lines (except in cases of farm installation) building location and showing exact location of waste line from house. Designate direction of slope and distance to house from property lines, and distance of all nearby sources of water to sewage disposal system.

Location and type of disposal system and well will be determined from results of percolation test.

Note: Notify the County Health Department at least forty eight (48) hours before you are ready to start installation, so inspection can be made while work is in progress.

Representatives of the County Health Department may make inspections during construction to determine compliance with the Regulations of the State Board of Health and the Local Board of Health. No part of any installation shall be covered until inspected and given final written approval by the County Health Department. Any part of an installation which has been covered prior to final approval shall be uncovered on order of the County Health Department.


Application approved: Application disapproved:

Reason for disapproval: _____

DATE: Oct 31 - 1968

Sanitarian

Supervisor

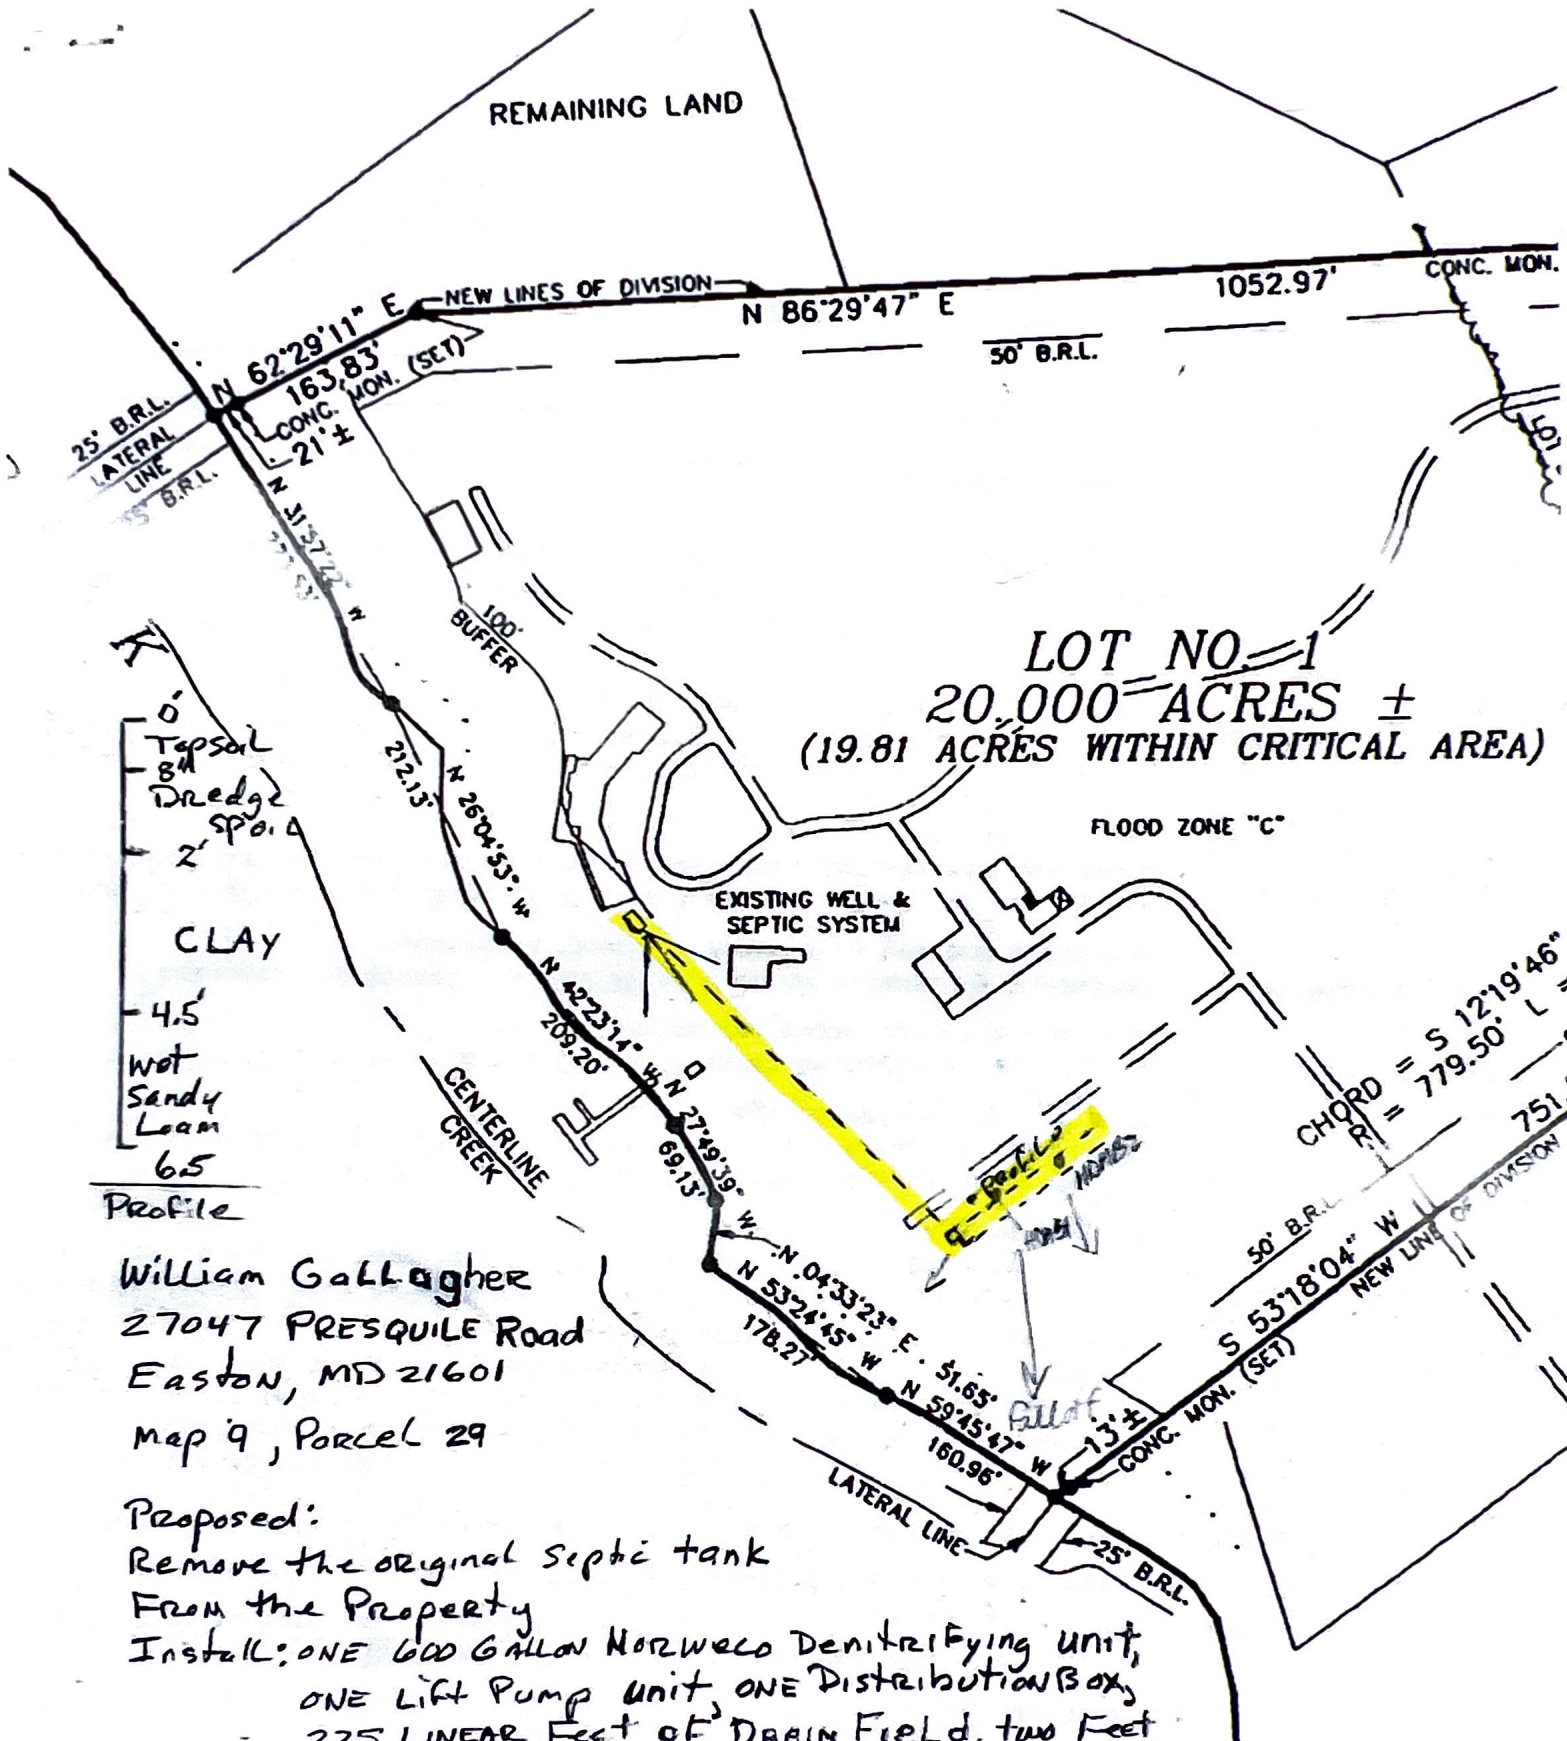

LOT NO. 1
20,000 ACRES ±
(19.81 ACRES WITHIN CRITICAL AREA)

FLOOD ZONE "C"

EXISTING WELL & SEPTIC SYSTEM

0' Topsoil
 8" Dredge Spoil
 2'
 CLAY
 4.5' Wet Sandy Loam
 6.5'

Profile

William Gallagher
 27047 PRESQUILE Road
 Easton, MD 21601
 Map 9, Parcel 29

Proposed:

- Remove the original septic tank from the property
- Install: ONE 600 GALLON NORWECO Denitrifying unit,
- ONE Lift Pump unit, ONE Distribution Box,
- 225 LINEAR Feet of DRAIN Field, two Feet wide, SIX AND A HALF Feet Deep,
- Invert at the surface.

TYLER CONTRACTING Co, WRTM, 04/04/18, For Permit Purposes ONLY

PUBLIC WORKS AGREEMENT

PWA 18-22

TM 9, P 29

APR 27 2018

AGREEMENT FOR INSTALLATION OR UPGRADE OF ON-SITE SEWAGE DISPOSAL SYSTEM USING BEST AVAILABLE TECHNOLOGY THROUGH A GRANT OF BAY RESTORATION FUNDS FROM THE MARYLAND DEPARTMENT OF THE ENVIRONMENT

THIS AGREEMENT, made this 25th day of April, 2018, among William & Sue Gallagher ("Owners") concerning the Owner's real property located at 27047 Presquile Rd, Easton, the ("Subject Property"), Talbot County, Maryland, acting by and through its Department of Public Works ("County").

Recitals

WHEREAS, ongoing efforts to improve the water quality of the Chesapeake Bay and its tributaries include testing of new technology for on-site sewage disposal systems to determine their effectiveness in reducing nitrogen loading; and,

WHEREAS, the parties desire to enter into this Agreement to memorialize the terms and conditions upon which grant funding will be made available to Owner for the installation of a Best Available Treatment (BAT) on-site sewage disposal system and the rights, powers, privileges, duties, and liabilities of parties with respect to the installation, maintenance, testing, sampling, and operation of the BAT system.

NOW, THEREFORE, the parties hereto agree as follows:

1. Owner desires to install or have installed a BAT on-site sewage disposal system for the Subject Property and to participate in a pilot program designed to evaluate the effectiveness of that system in reducing nitrogen loading into the Chesapeake Bay and its tributaries.
2. Owner acknowledges the need for proper installation, testing, operation, and documentation of the performance of the BAT on-site sewage disposal system, and agrees to cooperate fully with the County and MDE to insure the results of this pilot program are accurate, complete, and scientifically valid to the greatest possible extent. To accomplish this result, Owner agrees that:



302 Dodson Avenue
P.O. Box 960
Saint Michaels, MD 21663
410-745-2323
410-745-2373 Fax

APR - 9 2018

Revised 911
address.

March 12, 2018

William Gallagher
27047 Presquile Road
Easton, MD 21601

Dear William Gallagher,

In response to your request for a septic system evaluation, we did an evaluation of the septic system on the property at ~~27045~~ Presquile Rd in Easton, MD;

care takes House 27047

Date of Inspection: March 08, 2018.

Original Installation Date: About 1968.

Location of System:

The septic system is located behind the house as shown on the diagram. (Not to scale). The tank was recently pumped as part of the current inspection.

Septic Tanks:

There is one, 1000 gallon concrete aerobic septic tank. The tank was in good and acceptable condition. An inlet baffle was never installed into this tank system. The lids are in good condition. The liquid level was normal in the septic tank. The sludge and scum levels were normal. Liquid from the tank then runs towards a distribution box. The septic tank was in good and acceptable condition.

Piping:

The septic system consists of cast iron and plastic pipe. The piping from the house to the septic tank is cast iron. The piping to the distribution box and drain fields is plastic pipe. The piping appeared in good and acceptable condition.

Distribution Box:

There is one concrete distribution box. The distribution box is in poor condition and should be replaced. 300 gallons of liquid was introduced into the distribution box and it drained toward the drain fields. The distribution box should be replaced as it has deteriorated over time.

Drain Field Trenches:

There are three drain field trenches totaling 225 feet of trench.


Each trench is approximately 75 feet in length. The trenches accepted liquid from the distribution box. Therefore, the absorption system is in good and acceptable condition.

Summary: The 1000 gallon septic tank is in good and acceptable condition. The septic tank drains into a distribution box. The distribution box is in poor condition and should be replaced. Attached to the rear of the distribution box are three drain field trenches. The drain field trenches did accept over 300 gallons of liquid. The absorption system is in acceptable condition.

Company Disclaimer

Based on what we were able to observe and our experience with on-site wastewater technology, we submit this Sewage Treatment System Inspection Report based on the present condition of the on-site sewage treatment system. Tyler Contracting Co. has not been retained to warrant, guarantee, or certify the proper functioning of the system for any period of time in the future. Because of the numerous factors (usage, soil characteristics, previous failures, etc.) which may effect the proper operation of a septic system, as well as the inability of our company to supervise or monitor the use or maintenance of the system, this report shall not be construed as a warranty by our company that the system will function properly for any particular buyer.

Tyler Contracting Co. disclaims any warranty, either expressed or implied, arising from the inspection of the septic system or this report. We are also not ascertaining the impact the system is having on the ground water. I have studied the information contained herein and that my assessment is honest, thorough, and to the best of my ability, correct.




John W. Tyler
Henry J. Tyler
Tyler Contracting Company
NAWT/MOWPA Certified Septic Inspector

GARY 13 NEW

Each Square Equals 5 Feet

27045

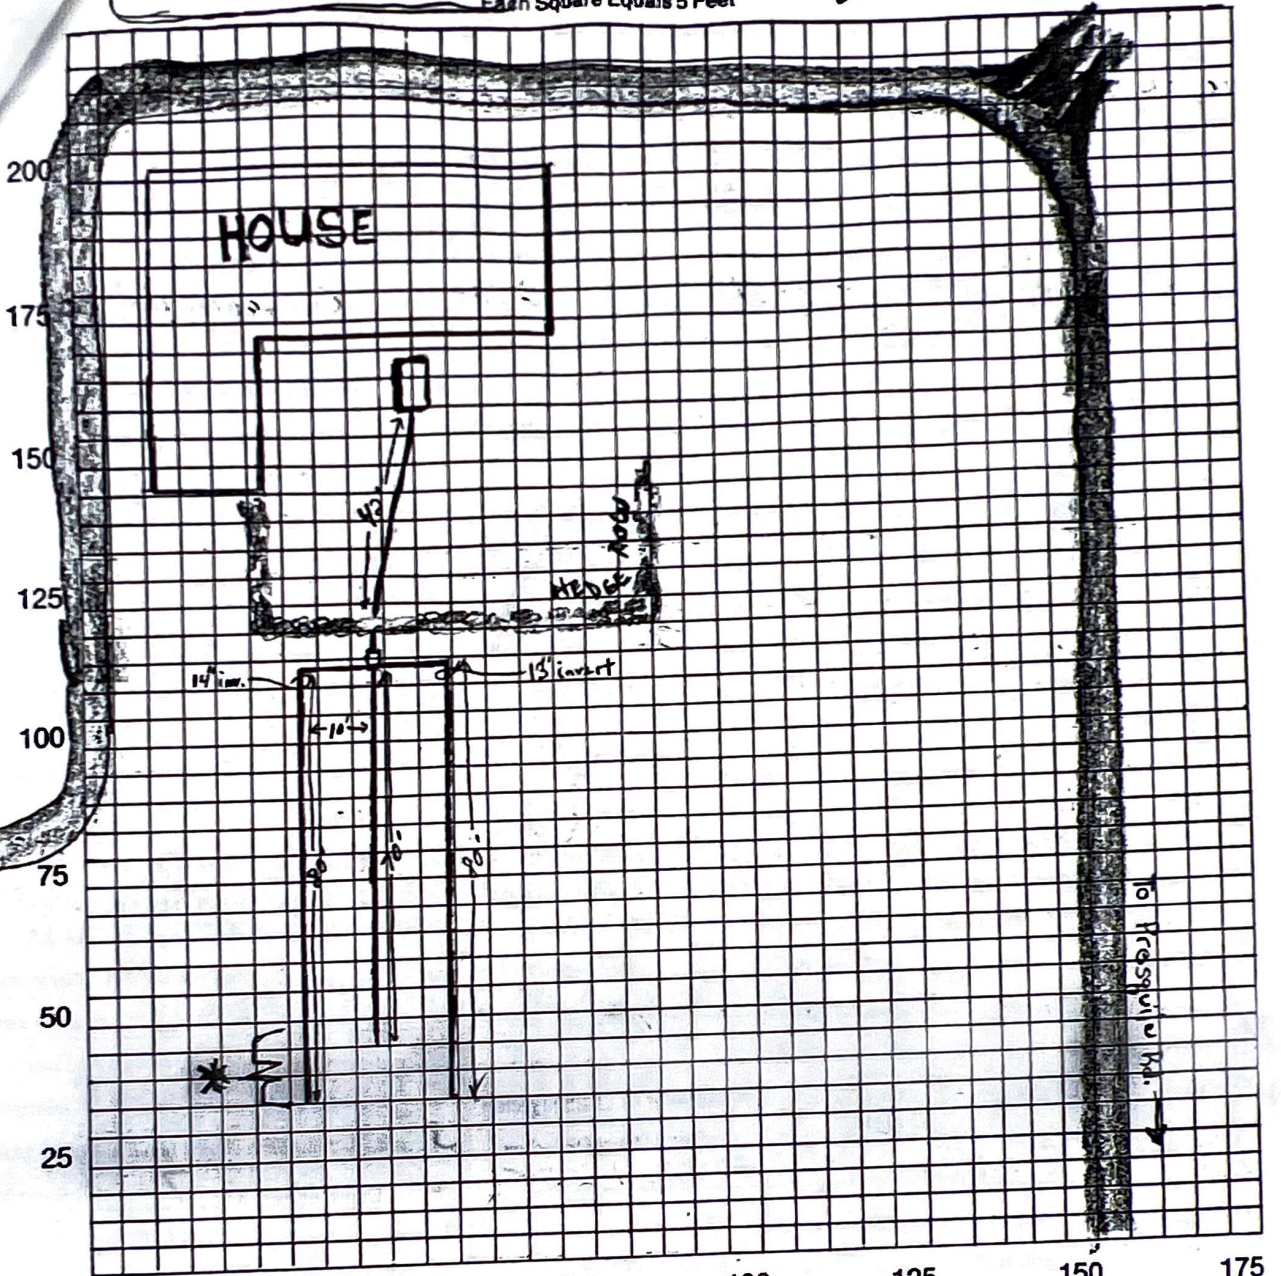

System Installed by B. Bishop

Note: Notify the County Health Department between the hours of 8-9 a.m. on the day of installation, so inspection can be made while work is in progress.

Representatives of the County Health Department may make inspections during construction to determine compliance with the Regulations of the State Board of Health and the Local Board of Health. No part of any installation shall be covered until inspected and given final written approval by the County Health Department. Any part of an installation which has been covered prior to final approval shall be uncovered on order of the County Health Department.

THERE WILL BE NO FINAL INSPECTIONS MADE ON WEEKENDS OR HOLIDAYS

Final Inspection: Repair to system. Connected new system to old tank. Gravity fed to D-box. 3-Tiles of perforated 4" pvc. 2-80'L ÷ 1-70'L. Trench Depth was 75', Width was 2'. Soil at bottom side wall of trench was light grey, sandy loam. Tile field was laid level and covered with stone 6" below pipe and 2" on top. This section (*) of pipe is containing more stone in trench than sand. (They were running low on sand.) Invert readings are stated in diagram.

Date 12/1/94

Time 10:00

Sanitarian

George Maurier

D. Kern, RS

#270407

Tenant house w/ well

Officer

TALBOT COUNTY HEALTH DEPARTMENT
P.O. BOX 480
EASTON, MARYLAND 21601
820-8213

Cary I. Rinehart
Director of Environmental Health

Permit No. _____

10/24/94

APPLICATION FOR SANITARY CONSTRUCTION PERMIT

This permit is for an interim individual system. The property owners must discontinue use of this individual system & connect to the community system when the community system becomes available

THIS APPLICATION MUST BE ACCOMPANIED BY A SITE PLAN OF THE PROPERTY.

1. OWNER Belmont August Last Name First Name P.O. Address 27045 Presquite Rd court Rd Farm Phone No. _____
 2. APPLICANT August Belmont GENERAL CONTRACTOR Richard Bishop

3. Give directions to property including subdivision name and lot number.
First Farm on left on Presquite rd.

4. Size of Lot Farm 5. Type of Construction: New Building Repair Conn. to sewer
 Remodeling Mobile Home

6. Planned use of building: Residence Commercial # of persons using 24 hr. 3
 Sq. Ft. of Living area _____ # of Bedrooms 3 Type rancher
 Garbage Disposal Yes No Ground Water Heat Pump Yes No Jacuzzi tub # of gals. _____

7. Type of sewage disposal system:
 Septic Tank System Connection to Public Sewer Other _____

8. Type of water supply: Deep Shallow Distance of water supply to disposal system 100'
IMPORTANT: NO BUILDING CONSTRUCTION OR SANITARY CONSTRUCTION SHALL BE STARTED BEFORE RECEIVING APPROPRIATE PERMITS. ANY CHANGES IN SANITARY CONSTRUCTION MUST HAVE THE APPROVAL OF THE SECTION OF ENVIRONMENTAL HEALTH OF TALBOT COUNTY HEALTH DEPARTMENT.

9. Soil test results: Percolation Rate _____ minutes. Infiltration rate _____ ft. Soil Type ?
 Soil test made by See proposal by Buddy Bishop

10. Septic Tank Specifications: Number of tanks Existing
 800 gallon 1,000 gallon 1,500 gallon two compartment 1,500 gallon

11. Tile field (if used): Total length of tile 225 ft. Number of trenches 3
 Length of each trench 75 ft. Width of each trench 225 ft. Depth of trench 7

12. Seepage pits (if used): Total depth _____ ft. Size _____ ft. Eff. depth _____ Number _____
 13. Additional system specifications: Sand lined trench ; 6" stone below & 2" above ; 8" tubing _____
 10" tubing _____; Invert of drainfield Existing Tank; Pump needed _____
 Install when ground water table is absent ; Mound over trench

14. Recommendations:
See site plan by Buddy Bishop for additional detail.
Note - keep invert as high as possible (12"), D. Russ

15. August Belmont (Signature of Owner)

hereby agree to have the sewage disposal facilities installed in accordance with regulations COMAR 26.04.02 of the Dept. of Health & Mental Hygiene under the supervision of the Talbot County Health Department. I also agree to notify the Talbot County Health Department before actual construction is begun. Should this system fail, I agree to make any changes deemed necessary.

THIS APPLICATION SHALL EXPIRE ONE YEAR FROM DATE OF ISSUE PROVIDED CONSTRUCTION HAS NOT BEGUN, OTHERWISE, IT IS VALID FOR TWO YEARS.

16. Application approved _____


10/26/94

Richard Russ, R.S.
Sanitarian

Subdivision _____
Map 9
Block 22
Parcel 7
Lot # _____


27017 - Tenant house?

Tenant house
w/ carport

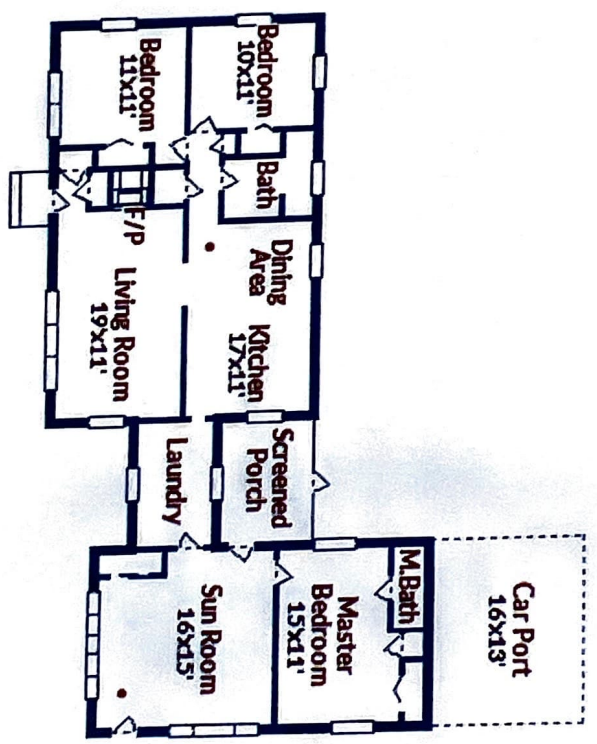


Copyright © TruePlace, Inc.

- Locations of water lines
- Provided by Board Benson/Bill Gallagher

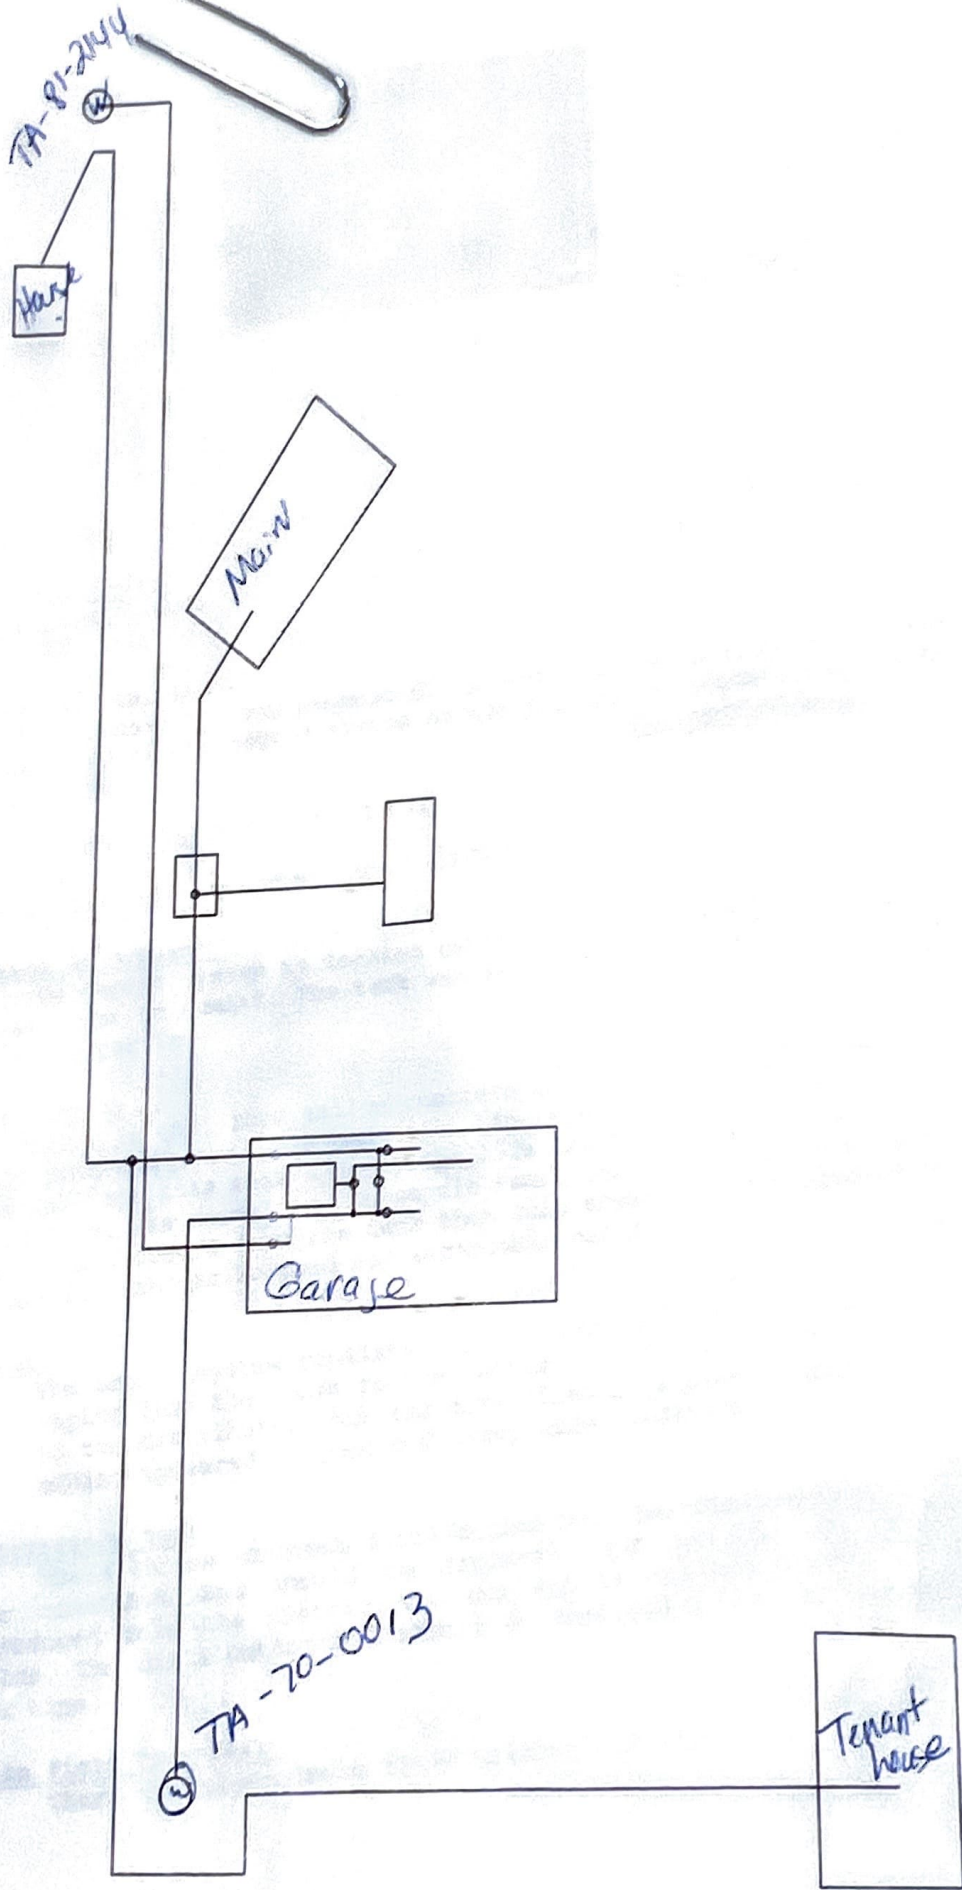

V. System Diagram
 For reproducible results, show dimensions from structures that will not change, such as corners of the house. Show details such as the road in relation to the house to get the correct orientation. Show all located components and attached dated photographs as supporting documentation.

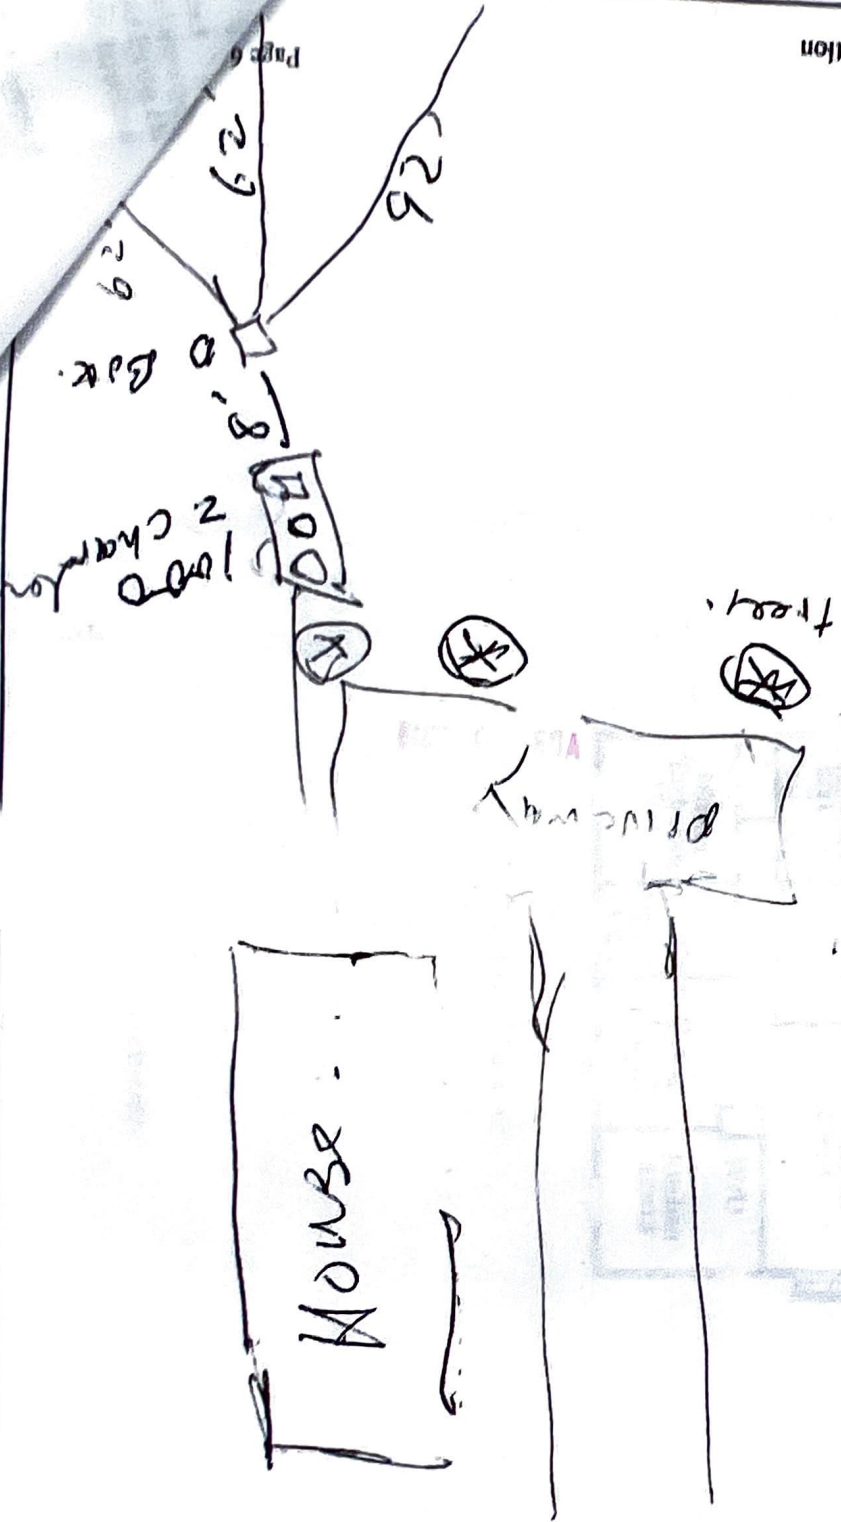


27049

27049 - Guest house

Number of rooms three

Rede Tyler

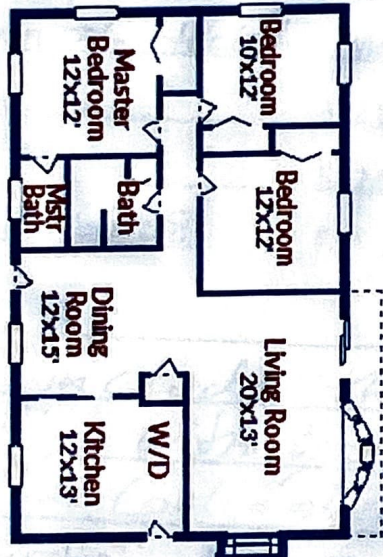

Copyright © TriPlace, Inc.

Handwritten notes:
Main
27049
27049

Handwritten notes:
Map 9, Grid

Handwritten notes:
Parcel 29

Handwritten notes:
- transfer to advance

Handwritten signature: Rede

P.O. Box 960
St. Michaels, MD 21148

6548

STATE OF MARYLAND
DEPARTMENT OF WATER RESOURCES
APPLICANT: BELMONT COURT ROAD FARM, EASTON, MARYLAND
APPLICATION FOR PERMIT TO DRILL WELL

APPLICATION MUST BE SUBMITTED AND PERMIT RECEIVED BEFORE DRILLING IS STARTED. FILE IN THIS FORM COMPLETELY.

OWNER: Belmont August
ADDRESS: Court Road Farm
CITY: Easton, Md. 21601

DRILLER INFORMATION

DRILLER: MAHARAJAN AND SONS
P.O. Box 217
St. Michaels, Md. 21663
DATE OF OPERATION: July 8, 1969

LOCATION OF WELL

COUNTY: Talbot
SUBDIVISION: No. 100-200-100-100-100
SECTION: 100
NEAREST TOWN: Easton
MILES FROM TOWN: 7

WELL INFORMATION

MAXIMUM FLOW RATE (GALLONS PER MINUTE): 30
AVERAGE DAILY QUANTITY (GALLONS PER DAY): 2000
USE FOR WATER: DOMESTIC; AGRICULTURE; INDUSTRIAL; MUNICIPAL WATER SUPPLY; PRIVATE WATER SUPPLY; TEST

DIRECTION FROM TOWN

DISTANCE FROM ROAD: 1000
DIRECTION: NORTH, EAST, SOUTH, WEST, NE, SE, SW, NW

APPROXIMATE DEPTH OF WELL

APPROXIMATE DEPTH OF WELL: 400
METHOD OF DRILLING USED: AIR-ROTARY
OTHER DESCRIBE: NONE


REPLACEMENT OR DEEPERED WELLS

THIS WELL WILL NOT REPLACE AN EXISTING WELL
THIS WELL WILL REPLACE A WELL THAT WILL BE ABANDONED AND SEALED

NOT TO BE FILLED IN BY DRILLER

Table with columns for APPROPRIATION, CONDITION, and other technical details.

DRAW A SKETCH BELOW SHOWING LOCATION OF WELL IN RELATION TO NEARBY LOTS, ROADS AND STREAMS WITH NORTH IN THE DIRECTION OF THE ARROW, AND GIVE DISTANCE FROM WELL TO NEAREST HIGH JUNCTION OR RIVERM CROSSING SHOWING THE BEARING. DISTANCE MAY BE APPROXIMATE, BUT MUST BE INDICATED.

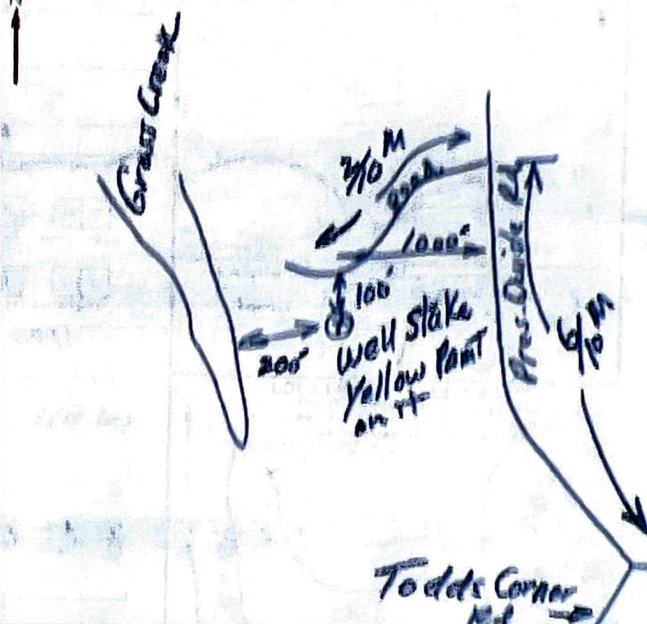

HEALTH DEPARTMENT APPROVAL (NOT TO BE FILLED IN BY DRILLER)

APPROVED BY: [Signature]
DATE: 7/12/69
TITLE: [Signature]

**STATE OF MARYLAND
DEPARTMENT OF WATER RESOURCES
STATE OFFICE BLDG., ANNAPOLIS, MARYLAND 21401
WELL COMPLETION REPORT**

THIS REPORT MUST BE SUBMITTED
WITHIN 30 DAYS AFTER COMPLETION
OF THE WELL

FILL IN THIS FORM COMPLETELY

SEQUENCE NO. (DWR USE ONLY)
0047
(SEQ. NO.)
NUMBER IS TO BE PUNCHED
(SLS. 3-6 ON ALL CARDS)

DATE RECEIVED (DWR USE ONLY)

WELL COMPLETED **Nov 18, 69**

DEPTH OF WELL

442
22 (TO NEAREST FOOT) 28

PERMIT NO. FROM PERMIT TO DRILL WELL

TA-70-0013
28 29 30 31 32 33 34 35 36 37

DRILLERS IDENTIFICATION NO. **024**

OWNER **Belmont August**
LAST NAME FIRST NAME

STREET OR RFD **Court Rd Farm** POST OFFICE **Easton, Md.**

WELL LOG

STATE THE KIND OF FORMATIONS PENETRATED, THEIR COLOR, DEPTH, THICKNESS AND IF WATER BEARING

DESCRIPTION (USE ADDITIONAL SHEETS IF NECESSARY)	FEET		CHECK IF WATER BEARING
	FROM	TO	
Brn Clay	0	7	
white clay, sand & small gravel	7	14	
Grn clay	14	39	
Grn clay, shell, & wood	39	94	
sandy grn clay gray & white	94	163	
sand & shell	163	173	
rock crust	173	173	16
rock	174	174	16
brn & blk sand	174	176-245	5
grn sandy clay	245	412	
brn & blk sand w/some shell	412	442	X

GROUTING RECORD

WELL HAS BEEN GROUTED (CIRCLE APPROPRIATE BOX)

ES NO
 Y N
46 48

DEPTH OF GROUT SEAL (TO NEAREST FOOT)

FROM **0** FT. TO **432** FT.
(ENTER 0 IF FROM SURFACE)

CASING RECORD

CASING TYPES
INSERT APPROPRIATE CODE BELOW

S STEEL
 C CONCRETE
 P PLASTIC
 O OTHER

MAIN CASING TYPE NOMINAL DIAMETER TOP (MAIN) CASING (NEAREST INCH) TOTAL DEPTH OF MAIN CASING (NEAREST FOOT)

S T **4** **161**

OTHER CASING (IF USED)

EACH CASING	DIAMETER (INCH)	DEPTH (FEET)	
		FROM	TO
<input checked="" type="checkbox"/> S <input type="checkbox"/> T	2	161	432
<input type="checkbox"/>			
<input type="checkbox"/>			

SCREEN RECORD

SCREEN TYPE OR OPEN HOLE
INSERT APPROPRIATE CODE BELOW

S STEEL
 B BRASS OR BRONZE
 P PLASTIC
 T TURBINE
 H OPEN HOLE
 O OTHER

DEPTH (NEAREST WHOLE FOOT)

FROM **432** TO **442**

EACH SCREEN	DEPTH (NEAREST WHOLE FOOT)	DEPTH (NEAREST WHOLE FOOT)	
		FROM	TO
<input checked="" type="checkbox"/> T	432	432	442
<input type="checkbox"/>			
<input type="checkbox"/>			

IF WELL DRILLED WAS A FLOWING WELL CIRCLE BOX F

DWR USE ONLY (NOT TO BE FILLED IN BY DRILLER) (E.R.O.)

TELESCOPE CASING LOG INDICATOR

OTHER DATA AVAILABLE

C 3

PUMPING TEST

HOURS PUMPED (TO NEAREST HOUR) **6**

PUMPING RATE (GALLONS PER MINUTE TO NEAREST GALLON) **25**

METHOD USED TO MEASURE PUMPING RATE **BUCKET**

WATER LEVEL: (DISTANCE FROM LAND SURFACE)

BEFORE PUMPING **24** (NEAREST FOOT)

WHEN PUMPING **50** (NEAREST FOOT)

TYPE OF PUMPED USED (CIRCLE APPROPRIATE BOX)

A AIR
 P PISTON
 T TURBINE
 C CENTRIFUGAL
 R ROTARY
 O OTHER (DESCRIBE BELOW)
 J JET
 S SUBMERSIBLE

PUMP INSTALLED

TYPE OF PUMP (WRITE APPROPRIATE LETTER IN BOX - SEE ABOVE) A, C, J, P, R, S, T, O

CAPACITY:
GALLONS PER MINUTE (TO NEAREST GALLON) **35**

PUMP HORSE POWER **37**


PUMP COLUMN LENGTH (NEAREST FOOT) **41**

CASING HEIGHT (CIRCLE APPROPRIATE BOX AND ENTER CASING HEIGHT)

ABOVE LAND SURFACE
 BELOW

49 (NEAREST FOOT)

LOCATION OF WELL ON LOT
SHOW PERMANENT STRUCTURE SUCH AS BUILDINGS, SEPTIC TANKS, AND/OR OTHER LAND MARKS AND INDICATE NOT LESS THAN TWO DISTANCES (MEASUREMENTS TO WELL).

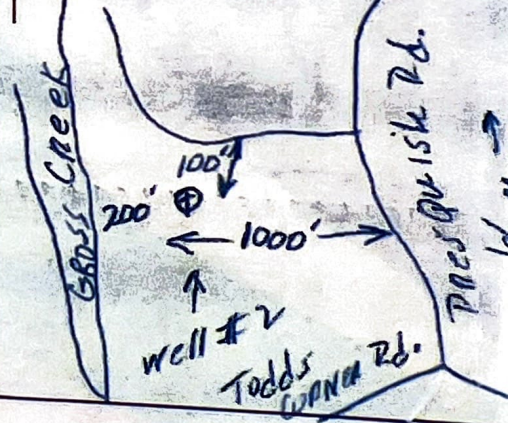

CIRCLE APPROPRIATE BOXES

A A WELL WAS ABANDONED AND SEALED WHEN THIS WELL WAS COMPLETED

E ELECTRIC LOG OBTAINED

C COPY OF ELECTRIC LOG ATTACHED

I HEREBY CERTIFY THAT I HAVE COMPLIED WITH ALL CONDITIONS STATED ON THE ABOVE-CAPTIONED "PERMIT TO DRILL WELL", AND THAT INFORMATION CONTAINED IN THIS REPORT IS TRUE, ACCURATE, AND COMPLETE TO THE BEST OF MY KNOWLEDGE, INFORMATION AND BELIEF.

DRILLERS NAME
(PLEASE PRINT) **Norman M. Shanahan III**
SIGNATURE *Norman M. Shanahan III*

ON THE LANDS OF WILLIAM L & SUE H GALLAGHER

IN THE FIRST ELECTION DISTRICT
TALBOT COUNTY, MARYLAND

GRID 22
PARCEL 29


SHEET NO. 1
OF 1
FILE NO. 9779

SITE PLAN


T.D.L.
APPROVED
DWG. NAME
CLM
DRAWN BY
DATE
SCALE
JOB NO.
02033
12-12-02

Civil Engineers - Land Planning - Land Surveyors
Lane Engineering, Inc.
 E-mail: me@lane.com
 408 N. Washington St. Eastern, MD 21601 (410) 822-8003 FAX (410) 822-2024
 13 Washington St. Cambridge, MD 21613 (410) 221-0818 FAX (410) 476-8842
 1148 West Water St. Centreville, MD 21617 (410) 758-2085 FAX (410) 758-4422

SCALE

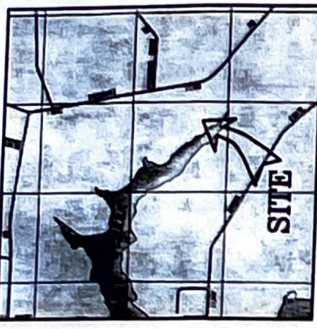

VICINITY MAP
 SCALE 1" = 2000'
 Copyright of the ADC Map People
 Permitted Use No. 20992180

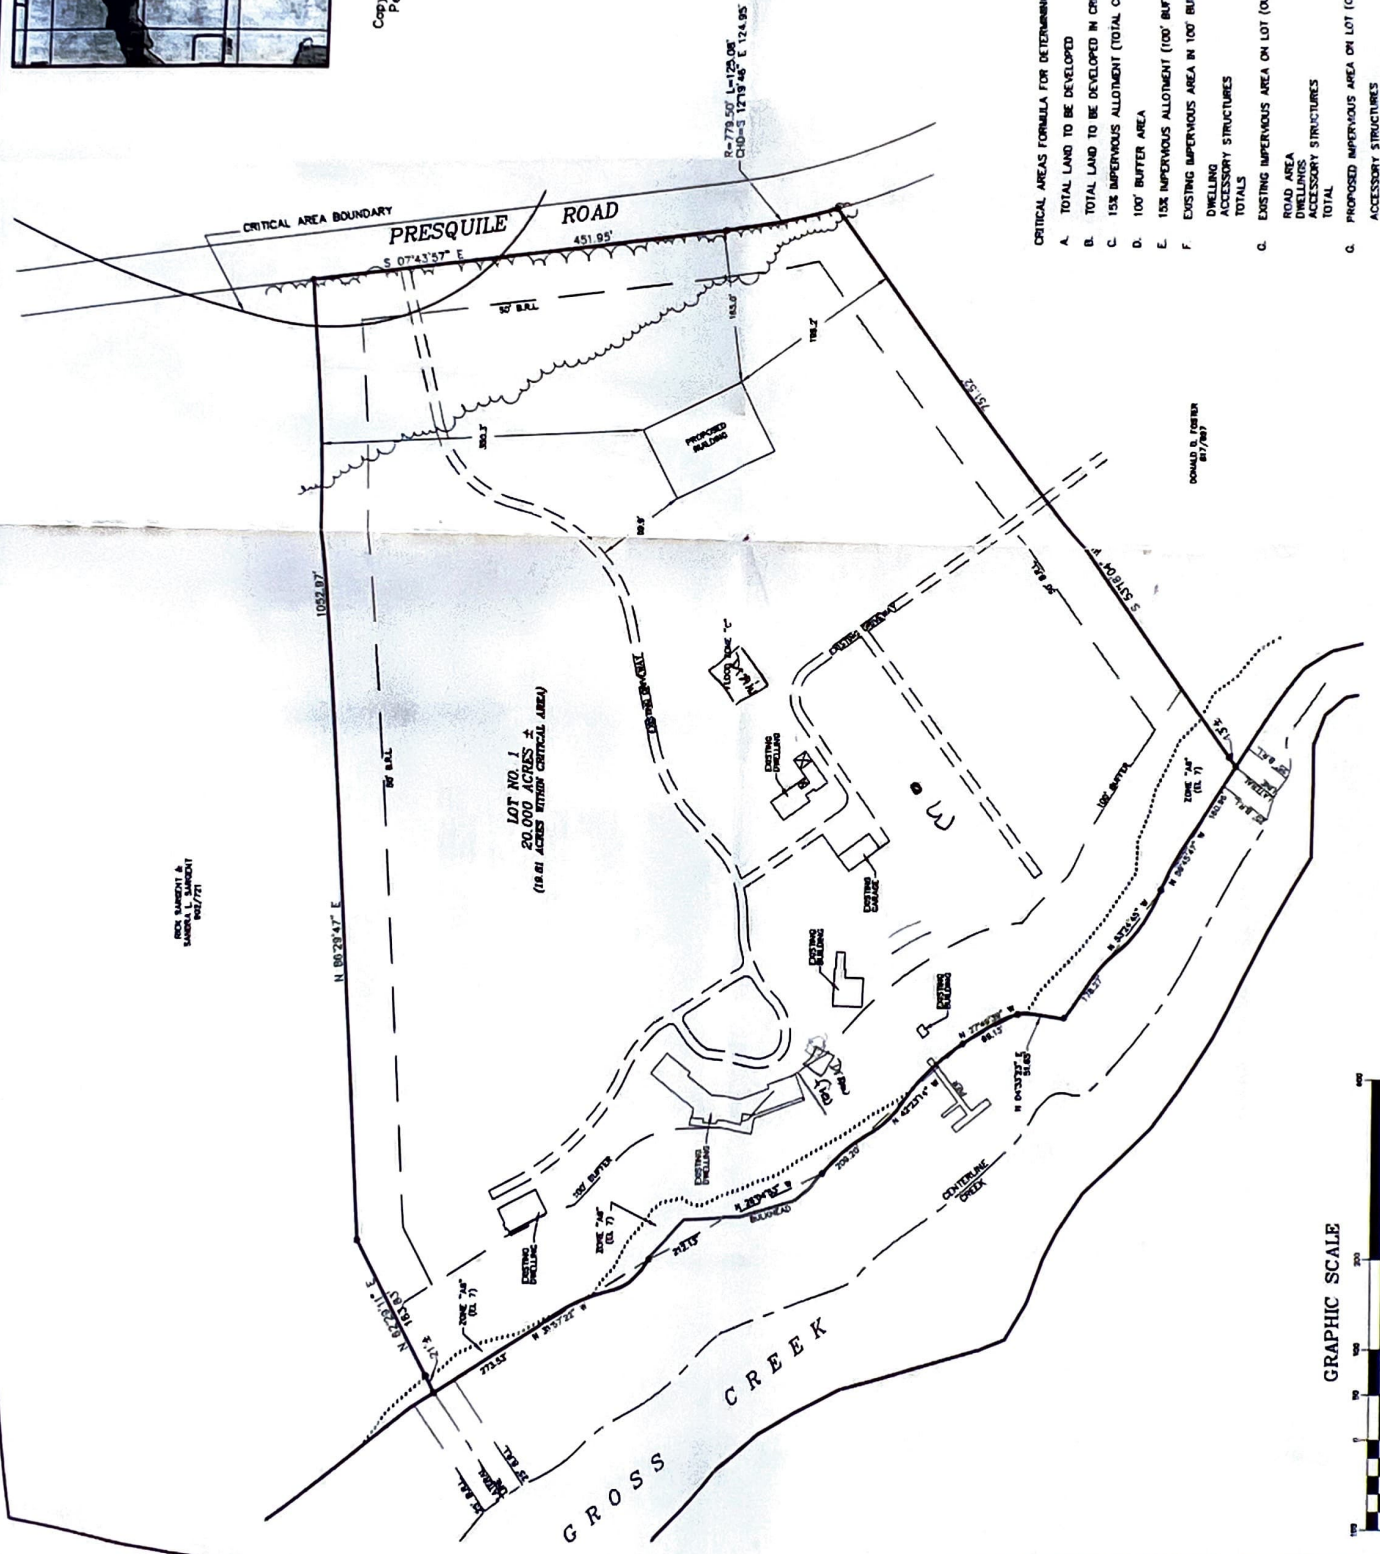

CRITICAL AREAS FORMULA FOR DETERMINING IMPERVIOUS SURFACE ALLOTMENT

A. TOTAL LAND TO BE DEVELOPED	871,200 SQ. FT.
B. TOTAL LAND TO BE DEVELOPED IN CRITICAL AREA	862,824 SQ. FT.
C. 15% IMPERVIOUS ALLOTMENT (TOTAL CRITICAL AREA LAND)	129,424 SQ. FT.
D. 100' BUFFER AREA	115,858 SQ. FT.
E. 15% IMPERVIOUS ALLOTMENT (100' BUFFER AREA)	17,378 SQ. FT.
F. EXISTING IMPERVIOUS AREA IN 100' BUFFER	1,535 SQ. FT.
DWELLING ACCESSORY STRUCTURES	101 SQ. FT.
TOTALS	1,636 SQ. FT.
G. EXISTING IMPERVIOUS AREA ON LOT (OUTSIDE 100' BUFFER)	20,750 SQ. FT.
ROAD AREA DWELLINGS	7,100 SQ. FT.
ACCESSORY STRUCTURES	1,000 SQ. FT.
TOTAL	30,850 SQ. FT.
H. PROPOSED IMPERVIOUS AREA ON LOT (OUTSIDE 100' BUFFER)	10,200 SQ. FT.
ACCESSORY STRUCTURES	10,200 SQ. FT.
TOTAL	41,000 SQ. FT.

NOTE:
 THE FLOOD ZONES AS SHOWN HEREON WERE TAKEN FROM
 F.E.D.M.C. COMMUNITY-PANEL NUMBER 2-1008 DUID A.

